



INVITATION FOR BID (IFB)

Name of Good or Service Requested: STRIPING AND ROAD MARKINGS FOR 11 ROUNDABOUTS

Contents:

- A. Summary of Invitation for Bid
- B. Instructions to Bidders
- C. Contract Requirements and Specifications
- D. Pricing and Addendum
- E. Standard Terms and Conditions
- F. Intent to Respond Form
- G. Questions

Attachment A – Master Q & A Form



A. Summary of Invitation for Bid

This bid is for the purpose of entering into a contract for STRIPING AND ROAD MARKINGS FOR 11 ROUNDABOUTS for the City of Billings. The successful bidder agrees to provide the City of Billings with an acceptable quality of equipment/service, performance and workmanship as determined by the City of Billings.

It is the purpose of this bid to obtain the best quality of equipment/service at the most favorable price to the City of Billings. Consideration will be given for the level of service offered and ability to meet stated specifications as outlined in the contract documents.

The lowest bid need not be accepted if it is documented that a specific supplier in the past has been a poor performer or has provided poor goods.

B. Instructions to Bidders

Sealed bids entitled STRIPING AND ROAD MARKINGS FOR 11 ROUNDABOUTS for the City of Billings Street/Traffic Division, Public Works Department, Billings, Montana, will be received by the City Clerk up until 2:00 PM (MST) on Tuesday, October 4, 2022.

All bids may be submitted to the Billings City Clerk, via email at bids@billingsmt.gov or via mail or delivery at 210 N. 27th Street, Billings, MT 59101 (P. O. Box 1178, Billings, MT 59103). Bids will be publicly opened and read aloud via Facebook Live on the City's Facebook page: <https://www.facebook.com/Billings-MT-City-Government-74352842013/>. Bid tabulations will be posted for public viewing after the bids have been opened.

More specific additional information regarding this STRIPING AND ROAD MARKINGS FOR 11 ROUNDABOUTS may be obtained by contacting Derick Miller via telephone at 406-657-8354, or via email at millerd@billingsmt.gov.

Each bid must be accompanied by a Certified Check, Cashier's Check, or Bid Bond payable to the City of Billings, Montana, in the amount not less than ten percent (10%) of the total amount of the bid. The bid security will be retained by the City Clerk until the successful bidder enters into a contract with the City of Billings. If no contract is entered into, by the successful bidder, within sixty (60) days the security may be forfeited to the City of Billings.



Successful bidders will be required to furnish an approved Performance Bond and Labor and Materials Payment Bond in the amount of one hundred percent (100%) of the contract amount.

No bids may be withdrawn after the scheduled time for the public opening of bids, which is 2:00 PM (MST) on Tuesday, October 4, 2022.

The right is reserved to reject any or all bids received, to waive irregularities, to postpone the award of the contract for a period of not to exceed sixty (60) days, and to accept that bid which is in the best interests of the City of Billings, Montana.

The City of Billings is an Equal Opportunity Employer. The Contractor and subcontractor shall abide by the requirements of 41 CFR 60-300.5(a) and 41 CFR 60-741.5(a), which prohibit discrimination against qualified protected veterans and/or qualified individuals on the basis of disability, and requires affirmative action by covered prime contractors and subcontractors to employ and advance in employment qualified protected veterans and individuals with disabilities.

EXAMINATION OF DOCUMENTS

Before submitting a bid, the bidder shall:

- a. Carefully examine the Standards and Specifications as well as all other attached documents;
- b. Fully inform themselves of the existing conditions and limitations;
- c. Include with the bid sufficient information to cover all items required in the specifications.

BID COMPLIANCE

It shall be the responsibility of the bidder to see that all bids are submitted to the office of the City Clerk before 2:00 PM (MST) on Tuesday, October 4, 2022.

BID MODIFICATIONS

Bids shall be made on the forms provided herein; they shall not contain any recapitulation of the work to be done. Modifications, additions or changes to the terms and conditions of this Invitation for Bid may be cause for rejection of the bid. Bids submitted on other forms may be rejected.

INTERPRETATION PRIORITY

Should a bidder find discrepancies in, or omissions from, the specifications, or be in doubt as to their meaning, bidder shall notify Derick Miller at 406-657-8354, who



will send written instructions or addenda to all bidders. The City will not be responsible for oral interpretation. All addenda issued prior to bid opening shall be incorporated into and become a portion and part of the contract/agreement upon award. Questions received less than ninety-six (96) hours before the bid opening cannot be answered.

WITHDRAWAL OF BIDS

Bidders may withdraw their bid either personally or by written request at any time prior to the time set for bid opening. No bid may be withdrawn or modified after the time set for opening, unless and until the award of the contract is delayed for a period exceeding sixty (60) days.

BID PRICE VALID

Bidder acknowledges that no contractual relationship with the Proposer exists until execution of the resulting contract following City Administration or City Council approval. Because contract approval can be delayed due to scheduling or unforeseen circumstances, the Bidder must honor their pricing and any other terms set forth in the proposal for at least ninety (90) days after the bid due date.

CERTIFICATION

The bidder certifies that the bid has been arrived at by the bidder independently and has been submitted without any collusion designed to limit independent bidding or competition. The bidder further certifies that the materials, products, services and/or goods offered herein meet all requirements of the stated specifications and are equal in quality, value and performance with highest quality, nationally advertised brand and/or trade names.

Any manufacturer's trade names, if used in specifications, are for the express purpose of establishing a standard of quality and coordination of design, not for the purpose of limiting competition.

INSURANCE

The bidder certifies that it/they shall maintain in good standing the insurance outlined below:

1. Workers' compensation and employer's liability coverage as required by Montana law.
2. Commercial general liability, including contractual and personal injury coverage's -- \$750,000 per claim and \$1,500,000 per occurrence.
3. Automobile liability -- \$1,500,000 per accident.
4. Professional liability in the amount of \$1,500,000 per claim.



Each policy of insurance required by this Section shall provide for no less than 30 days' advance written notice to the CITY prior to cancellation.

The CITY shall be listed as an additional insured on all policies except Professional Liability and Worker's Compensation Policies.

In addition, all policies except Professional Liability and Worker's Compensation shall contain a waiver of subrogation against the CITY.

BIDDER shall comply with the applicable requirements of the Workers' Compensation Act, Title 39, Chapter 71, MCA, and the Occupational Disease Act of Montana, Title 39, Chapter 71, MCA. Bidder shall maintain workers' compensation insurance coverage for all members and employees of Bidder's business, except for those members who are exempted as independent contractors under the provisions of §39-71-401, MCA.

The certificate will be provided to the City prior to contract execution.

ELIGIBILITY

The successful bidder will be required to provide copies of the following, or the ability to obtain the following within 15 days of notification of contract award:

- Completed and signed the new vendor forms, if necessary (to be eligible for payment): <http://mtbillings3.civicplus.com/DocumentCenter/View/26004>
- City of Billings Business License: <http://ci.billings.mt.us/981/Business-Licenses>
- Montana Contractor's License: <http://erd.dli.mt.gov/work-comp-regulations/montana-contractor/construction-contractor-registration>
- Certificate of Workman's Compensation or Certificate of Exemption from Workman's Compensation: <http://erd.dli.mt.gov/work-comp-regulations>

EVIDENCE OF QUALIFICATION

Upon request of the City of Billings, a bidder whose bid is under consideration for award may be required to manifest satisfactory evidence of his financial resources, experience, the organization and equipment as well as service provisions bidder has available or will make available. In determining the lowest responsible bidder, in addition to price, the following considerations may be addressed:

- a) The ability, capacity and skill of the bidder to perform the contract or provide the service required.
- b) The character, integrity, reputation, judgment, experience and efficiency of the bidder.



- c) Whether the bidder can perform the contract within time specified.
- d) The quality of performance of previous contracts, agreements and/or performance.
- e) Previous and/or existing compliance by the bidder with laws relating to the contract or services.
- f) Such other information which may be secured having a bearing on the decision to award the contract.

CONTRACTORS' GROSS RECEIPTS TAX AND PREVAILING WAGE RATES

The bidder understands that, if applicable, all contractors or subcontractors working on a publicly funded construction project are required to pay or have withheld from earnings one percent (1%) of the gross contract price if the gross contract price is Five Thousand Dollars (\$5,000) or more.

The bidder also understands that, if applicable and unless superseded by federal law, Montana law requires that contractors and subcontractors give preference to the employment of Montana residents for any public works contract in excess of \$25,000 for construction or nonconstruction services in accordance with sections 18-2-401 through 18-2-432, MCA, and all administrative rules adopted pursuant thereto. Unless superseded by federal law, each contractor shall ensure that at least 50% of the contractor's workers performing labor on a construction project are bona fide Montana residents. The Commissioner of the Montana Department of Labor and Industry has established the resident requirements in accordance with sections 18-2-403 and 18-2-409, MCA. Any and all questions concerning prevailing wage and Montana resident issues should be directed to the Montana Department of Labor and Industry.

C. Contract Requirements and Specifications

Please see Exhibits A and B for more detail about the STRIPING AND ROAD MARKINGS FOR 11 ROUNDABOUTS bid. This project must be completed before June 30th of the 2023 calendar year.

D. Pricing and Addendum

Please bid net prices at which you will agree to furnish required goods or services.

TOTAL BID PRICE - _____ dollars
(words)
and _____ cents (\$ _____)
(words) (figures)



I/We acknowledge _____ addendum.
#

Company Name

Date

Contact Name (please print)

Title

Signature of Contact Position

By signing the above, I certify that I am authorized by the Company named above to respond to this request.



E. Standard Terms and Conditions

In case of default by the successful bidder or failure to deliver the goods or services within the time specified, the City Purchasing Agent, after written notice, may procure them from other sources and hold contractor responsible for excess costs occasioned thereby.

The specifications attached to the instructions to bidders establish a standard of quality desired by the City of Billings. Any bidder may submit quotations on any article which substantially complies with these specifications as to quality, workmanship and service. The City of Billings reserves the right to make its selections of materials or services purchased, based on its best judgment as to which articles substantially comply with the requirements of the specifications.

No alteration in any of the terms, conditions, delivery, quality, or specifications will be effective without prior written consent of the City of Billings.

No exception to delivery or service dates shall be allowed unless prior written approval is first obtained from the City of Billings.

The contractor warrants all articles supplied under this contract to conform to specifications, herein. The contractor will deliver a warranty stating that all articles supplied under the contract are fit and sufficient for the purpose manufactured, merchantable, and free from defects.

In the event the City is entitled to a prompt payment or cash discount, the period of computation shall commence on the date of delivery, or receipt of correctly completed invoices, whichever is later. If an adjustment of payment is necessary, the discount period shall commence on the date final approval for payment is authorized.

The contractor agrees not to discriminate against any client, employee or applicant for employment or for services, because of race, creed, color, national origin, sex or age with regard to, but not limited to, the following: employment upgrading; demotion or transfer; recruitment or recruitment advertising; layoffs and termination; rates of pay or other forms of compensation; selection for training; rendition of services. It is further understood that any contractor who is in violation of this shall be barred forthwith from receiving awards of any purchase order for the City unless a satisfactory showing is made that discriminatory practices have terminated and that a reoccurrence of such acts are unlikely.

The City reserves the right to cancel and terminate this contract forthwith upon giving 30 days written notice to the contractor. (This provision does not apply to



the purchase of materials and equipment. A purchase order for materials and equipment is a binding contract.)

Should either party employ an attorney or attorneys or utilize the services of in-house attorneys to enforce any of the provisions hereof or to protect its interest in any manner arising under this contract, the non-prevailing party in any action pursued in a court of competent jurisdiction agrees to pay to the prevailing party all reasonable costs, damages, expenses, and attorneys' fees, including fees for in-house attorneys, expended or incurred in connection therewith.

Where applicable, possible or required, bidder is required to submit descriptive literature, sample material, design sketches and detailed shop drawings. Failure to submit required items may result in rejection of the bid or termination of contract.

The successful bidder may not make any advertising or sale use of the fact that contract items are being used by purchaser and other approved agencies, under penalty of contract termination.

This Agreement shall be construed and enforced in accordance with the laws of the State of Montana. Venue for any suit between the parties arising out of this Agreement shall be the State of Montana Thirteenth Judicial District Court, Yellowstone County.

Regardless of FOB point, contractor agrees to bear all risks of loss, injury, or destruction of goods and materials ordered herein and such loss, injury, or destruction shall not release contractor from any obligation hereunder.

All materials submitted in response to this IFB become public records under Article II, Section 9 of the Montana Constitution and §§ 2-6-102 and 7-1-4144, MCA and may be distributed by written request pursuant to Montana's Constitutional Right to Know or Public Records Acts.

Information provided in response to this IFB will be held in confidence and will not be revealed or discussed with competitors prior to award of Contract by Council. However, one copy of each bid submitted shall be retained for the official files of the Department and will become public record after award of the Contract.

Records and materials that are constitutionally protected from disclosure are not subject to the provisions of this section.



F. Intent to Respond Form

Email the following Intent to Respond form to Derick Miller within four (4) days of the Bid Opening date of October 4, 2022 even if your company chooses NOT to participate.

To: City of Billings – Public Works Department

Attn: Derick Miller

Phone: 406-657-8354

Email: millerd@billingsmt.gov

From: _____ Contact Name

_____ Company Name

_____ Company Address

_____ Email Address

_____ Phone Number

_____ Fax Number

Please indicate whether or not you intend to submit a bid on: STRIPING AND ROAD MARKINGS FOR 11 ROUNDABOUTS by checking Yes or No.

We intend to respond by the specified due date:

Yes _____ No _____

_____ Company Name

_____ Date

_____ Contact Name (please print)

_____ Title

_____ Signature of Contact Position

By signing the above, I certify that I am authorized by the Company named above to respond to this request.



G. Questions

Questions regarding this Invitation for Bids must be sent to the contact person listed in Section B no later than 5 business days prior to due date. The City will make every effort to provide a written response within 2 business days. Whenever responses to inquiries would constitute a modification or addition to the original IFB, the reply will be made in the form of an addendum to the IFB, a copy of which will be posted on the City's website and forwarded to all Suppliers who have submitted an "Intent to Respond" form (Section F).

Supplier must submit their questions via email using the "Master Q & A" form found below (Attachment A), and provide, at a minimum, the following:

- Supplier's name, requester, and appropriate contact information.
- The question, clearly stated.
- Specific reference to the applicable IFB section(s).

H. Protests

Any Bidder protest of award recommendations and/or bid specifications must be filed with the Purchasing Agent within seven (7) days of bid opening.

Upon receiving a written protest, the Purchasing Agent, with assistance from the Legal Department, determines if the protest has sufficient merit and if so, schedules an informal hearing with the protesting bidder and the user Department.

At this hearing, all parties discuss the basis of the protest and attempt to resolve the dispute based on fact. If the protesting party is not in agreement with the results of the informal hearing, they may appeal to the City Administrator.



ATTACHMENT A

MASTER Q & A FORM

IFB: STRIPING AND ROAD MARKINGS FOR 11 ROUNDABOUTS

Master Q&A	Any questions regarding this IFB should be submitted according to the process outlined below. The City will make every effort to answer within two (2) days of receiving the questions.
Q&A Process	<ol style="list-style-type: none">1. Prepare questions or concerns on the template provided.2. Complete the table in full, providing a date for each question and a section of the IFB to reference (if applicable).3. Submit the completed form via email to millerd@billingsmt.gov. Attach associated documents as necessary. <p>Please contact Derick Miller at 406-657-8354 with any questions regarding this process.</p>

Questions from: _____ **Company:** _____

Email Address: _____

#	Date	Reference Section	Question or Comment	City Response
1				
2				
3				
4				

STRIPING and ROAD MARKINGS FOR 11 ROUNDABOUTS IN BILLINGS, MT

1. **Description:** This bid describes striping and road markings for 11 roundabouts in Billings, MT. The bid will include all markings described in Exhibit B.
2. **Locations:**
 - Zoo Drive & Shiloh Rd
 - Hesper Rd & Shiloh Rd
 - Knife River & Shiloh Rd
 - King Ave West & Shiloh Rd
 - Monad Rd & Shiloh Rd
 - Central Ave & Shiloh Rd
 - Broadwater Ave & Shiloh Rd
 - Grand Ave & Shiloh Rd
 - Grand Ave & 38th St W
 - Grand Ave & 36th St W
 - Hilltop Road & Bench Blvd

Per Exhibit B.

3. **Marking Description:** Bid calls for all striping and markings including crosswalks, sharkteeth, arrows/onlys, fishhooks, white lane dividers, yellow edge lines, white fog lines, white skips, white islands and yellow islands.

All the above referenced striping and road markings is from the North-South, East-West, painted islands inward. On North leg of roundabouts: distances referenced are from the north side of north crosswalk. On South leg of roundabouts: distance referenced are from the south side of south crosswalk. On West leg of roundabouts: distance referenced are from west side of west crosswalk. On East leg of roundabouts: distance referenced are from east side of east crosswalk. The distances are noted on each drawing (Exhibit B).


Applied paint shall be Epoxy and include grinding/cleaning when necessary of existing markings prior to restriping.

4. **Traffic Control:** Provided by selected successful bidder

**ROUNDABOUT STRIPING &
PAVEMENT MARKING DETAIL (TYP.)**

As-Built

STATE	PROJECT NUMBER	SHEET NO.
MONTANA	ETRU 103000	1-8A

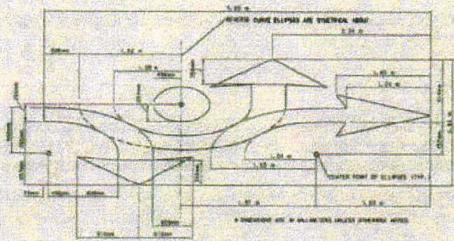

As-Built

STATE PROJECT NUMBER SHEET NO.



COMPONENT KEY

COMPONENT KEY
THE LABELED AREAS ABOVE CORRESPOND TO THE PORTIONS
NEEDED FOR EACH TYPE OF ROUNDABOUT TRAFFIC ARROW.

L = LEFT, T = THROUGH, R = RIGHT, E = ELLIPSE



TYPE LC



TYPE TE / TYPE LTE



TYPE I TE



TYPE TRE


lett

straight


Left
Right
Straight

MERGE ARROWS (20°) DETAIL

NO SCALE

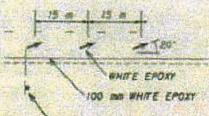


200 Ar ½ shiloh Rd

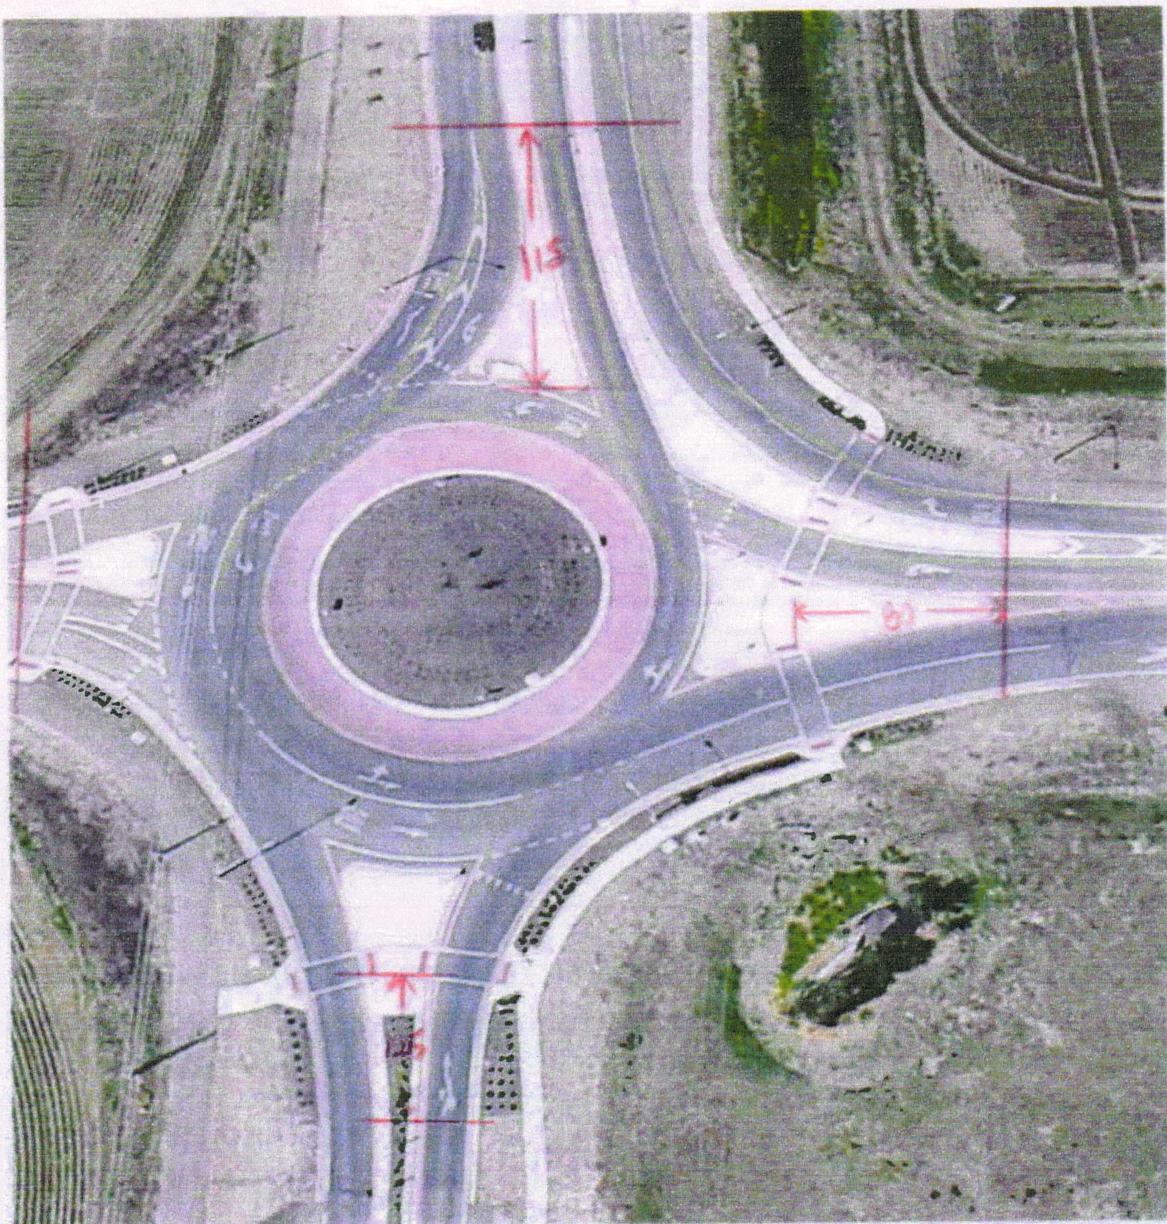


①	crosswalks	7	⑩	white fog line
②	shark teeth	6	⑪	yellow edge line
③	arrows →	2	⑫	white lane divider
④	arrow ↗	2	⑬	white skip
⑤	arrows ↑	2	⑭	white islands
⑥	arrows ↘	1	⑮	yellow islands
⑦	only	6		
⑧	fish hook straight	2		
⑨	fish hook left	2		

Hesper Rd & Shiloh Rd

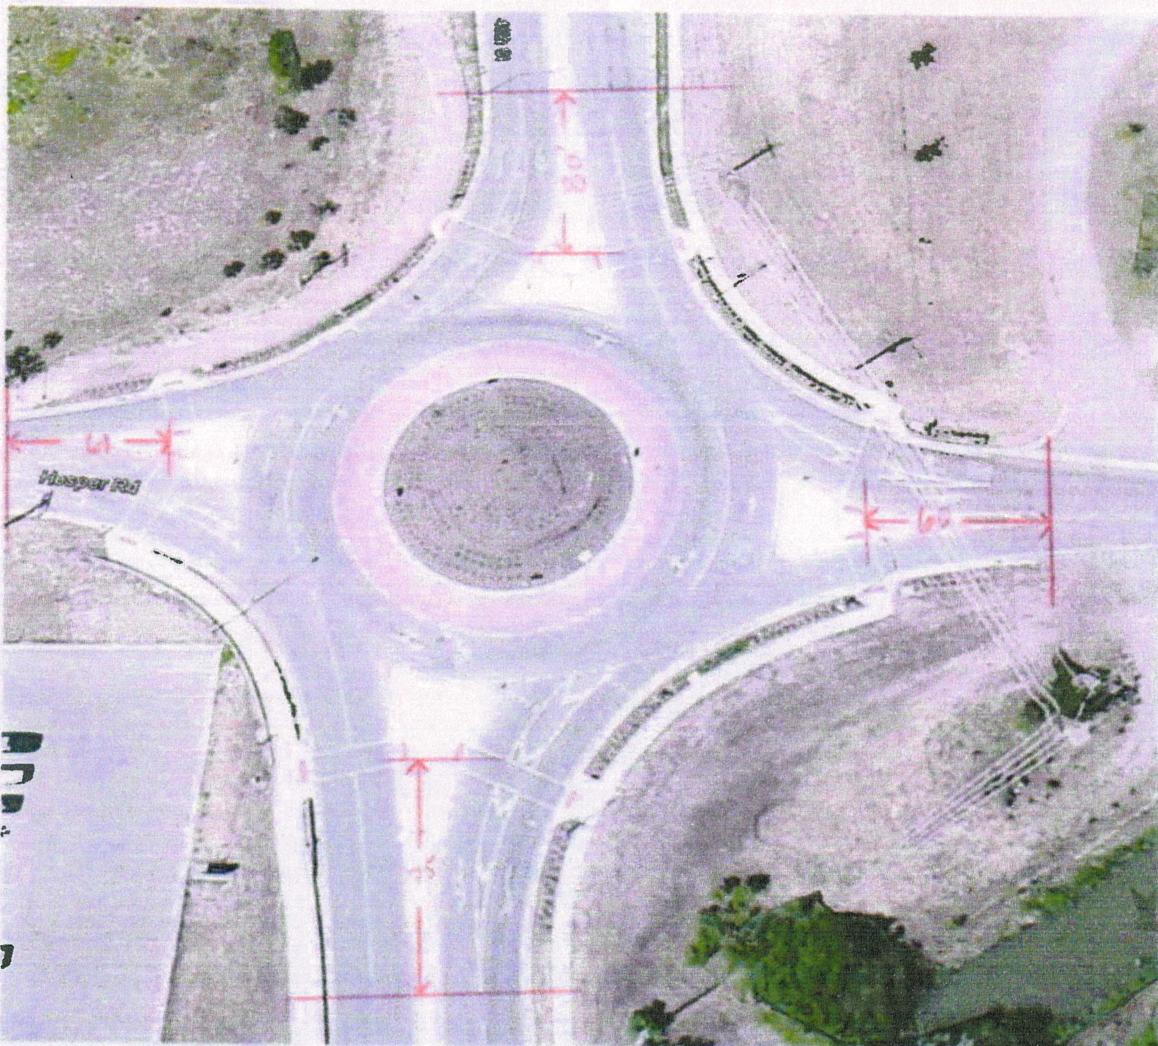

①	crosswalks	3	⑨	white fog line
②	shark teeth	8	⑩	yellow edge line
③	arrows →	2	⑪	white lane divider
④	arrows ↗	4	⑫	white skip
⑤	arrows ↘	2	⑬	white islands 1
⑥	onlys	4	⑭	yellow islands 2
⑦	fish hooks straight	2		
⑧	fish hooks left	1		


Knife River & Shiloh Rd

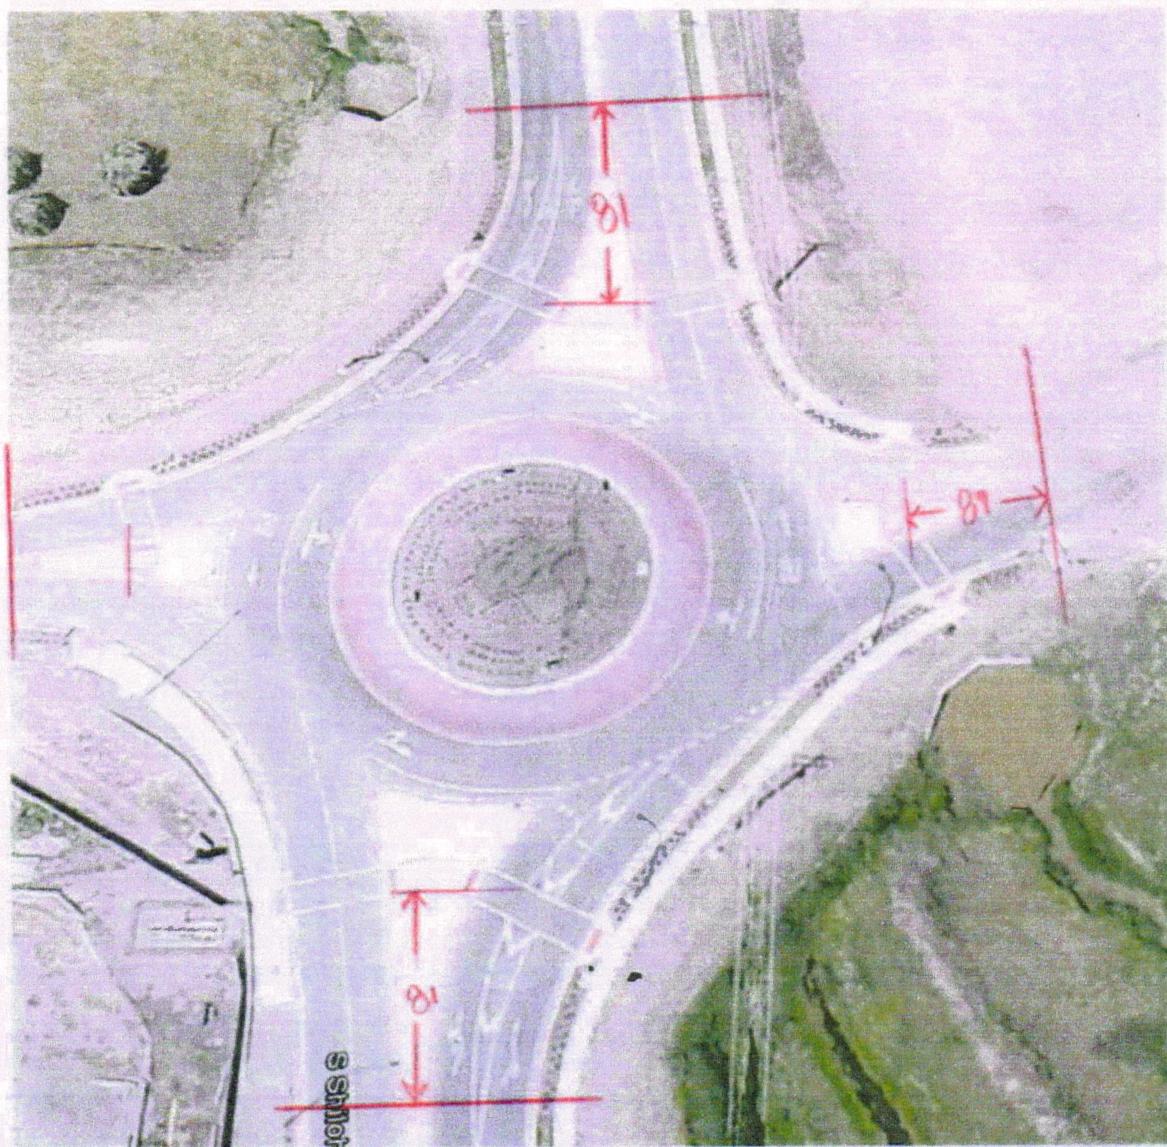


①	cross walks	8
②	shark teeth	6
③	arrows →	2
④	arrows ↗	4
⑤	only	2
⑥	fish hooks straight right	2
⑦	fish hooks left	2
	fish hooks LRS	1

⑧	white fog line
⑨	yellow edge line
⑩	white lane divider
⑪	white skip
⑫	white islands 2
⑬	yellow islands 1

King Ave W & Shiloh

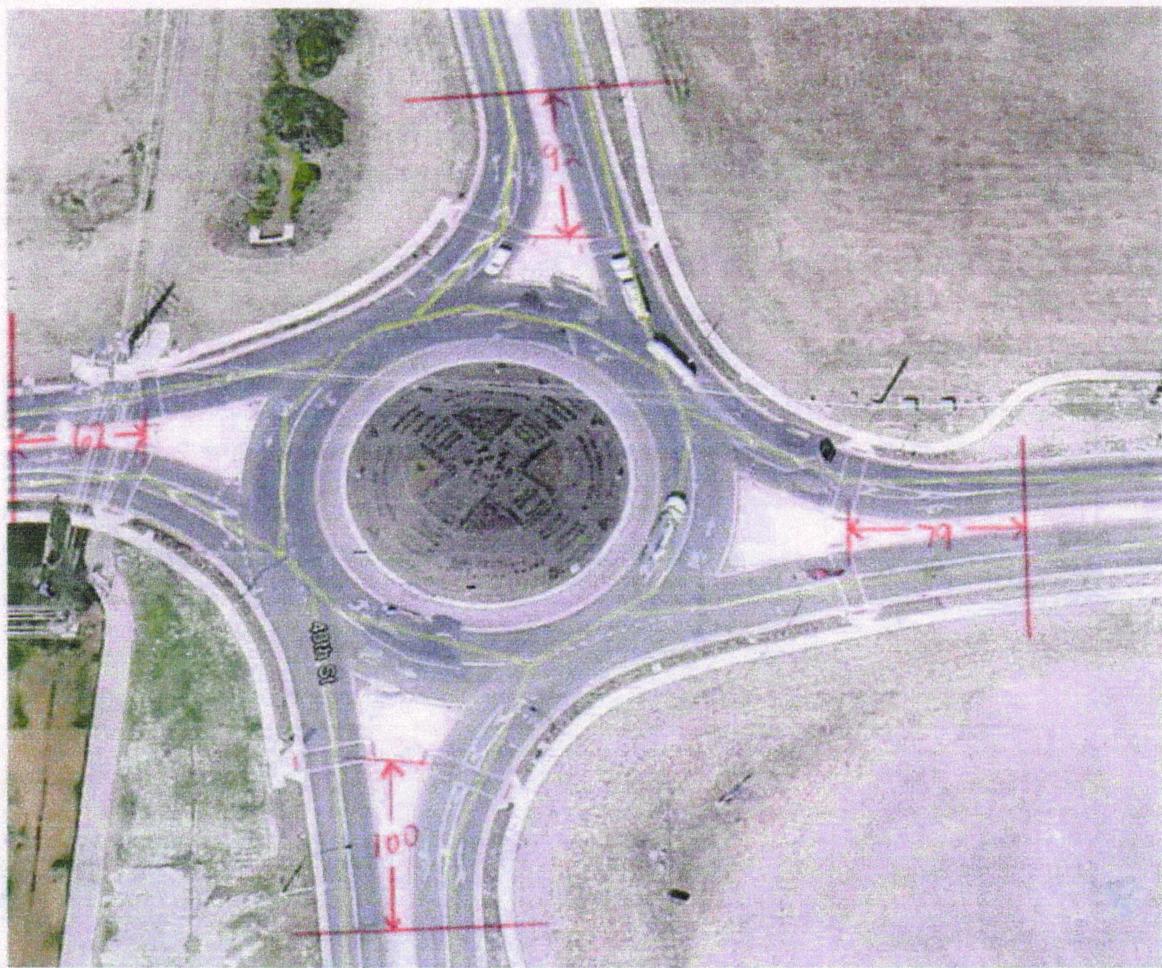


①	cross walks	8	⑧	white fog line
②	shark teeth	8	⑨	yellow edge line
③	arrows →	4	⑩	white lane divider
④	arrows ↗	4	⑪	white skip
⑤	onlys	1	⑫	white islands 4
⑥	Fish hooks straight	4	⑬	yellow islands
⑦	Fish hooks left	1		

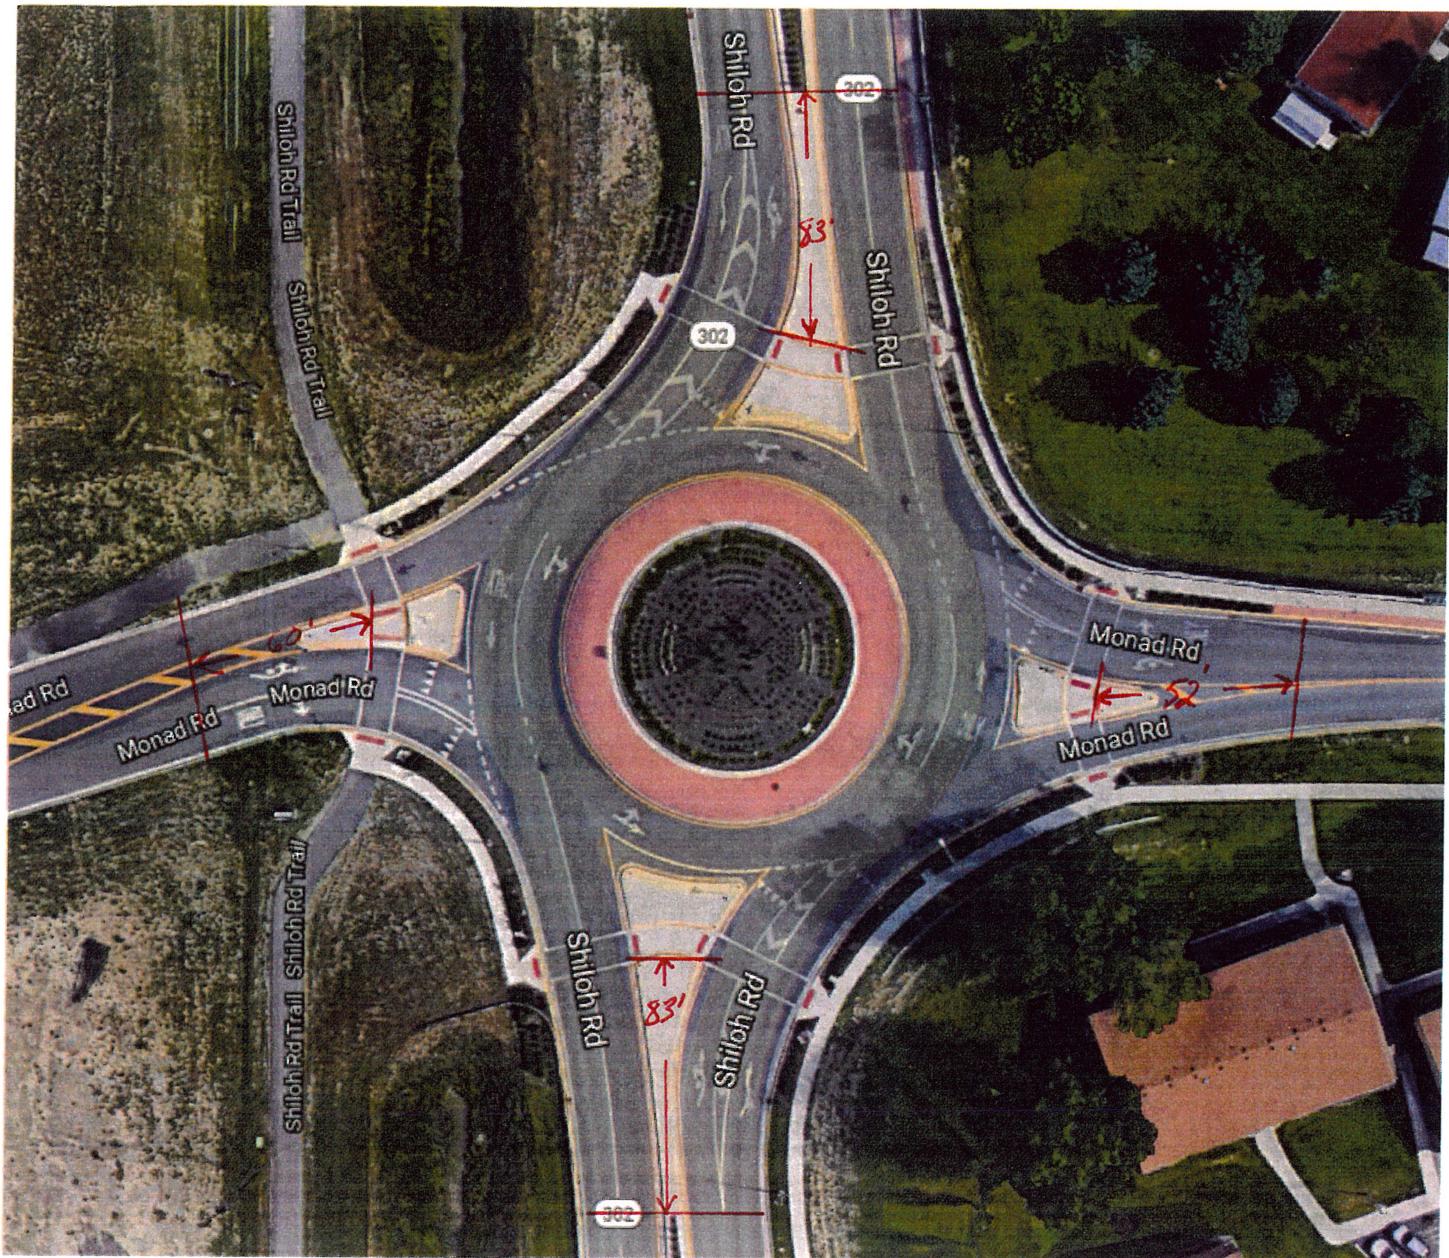


①	CROSSWALKS	8	⑨	WHITE FOG LINE
②	SHARKS TEETH	8	⑩	YELLOW EDGE LINE
③	ARROWS →	2	⑪	WHITE LANE DIVIDER
④	ARROWS ↗	4	⑫	WHITE SKIP
⑤	ARROWS ↘	2	⑬	WHITE ISLANDS 3
⑥	ONLY	4	⑭	YELLOW ISLANDS 2
⑦	FISH HOOKS STRAIGHT / RIGHT	2		
⑧	FISH HOOKS STRAIGHT / LEFT	4		

Central Ave & Shiloh Rd

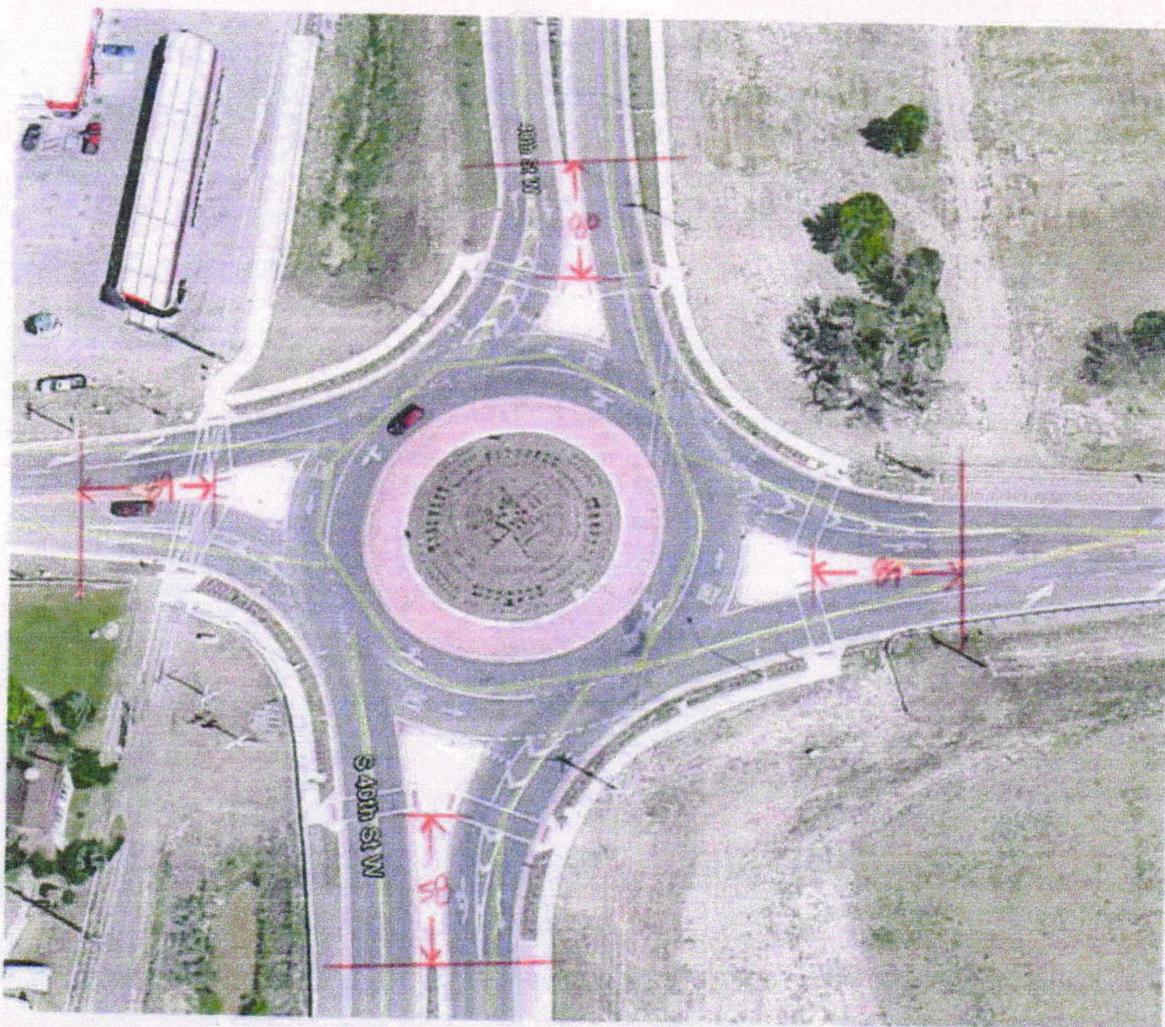

① crosswalks	8	⑦ white fog lines
② shank teeth	8	⑧ yellow edge line
③ arrows →	4	⑨ white lane divider
④ arrows ↗	4	⑩ white skip
⑤ onlys	4	⑪ white islands 4
⑥ fish hooks straight	4	⑫ yellow islands 2
⑦ fish hooks left	4	


Broadwater Ave & Shiloh Rd

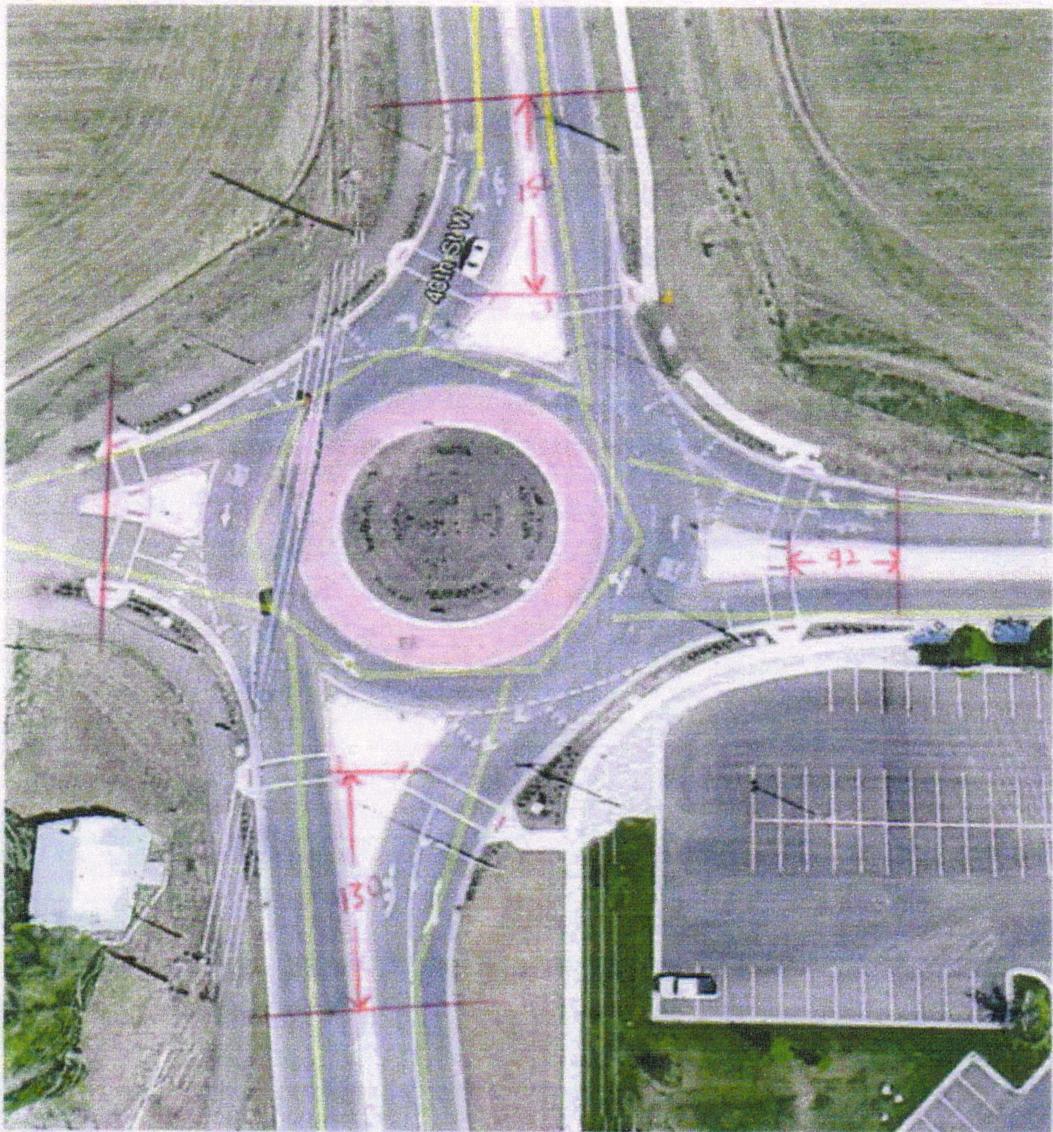

① cross walks	8
② shark teeth	8
③ arrows →	2
④ arrows →→	3
⑤ arrows ↓	2
⑥ onlys	5
⑦ fish hook straight	2
⑧ fish hook left	3
⑨ arrows ↴	1


⑨ white fog line	
⑩ yellow edge line	
⑪ white lane divider	
⑫ white skip	
⑬ white islands	3
⑭ yellow islands	

Grand Ave & Shible Rd

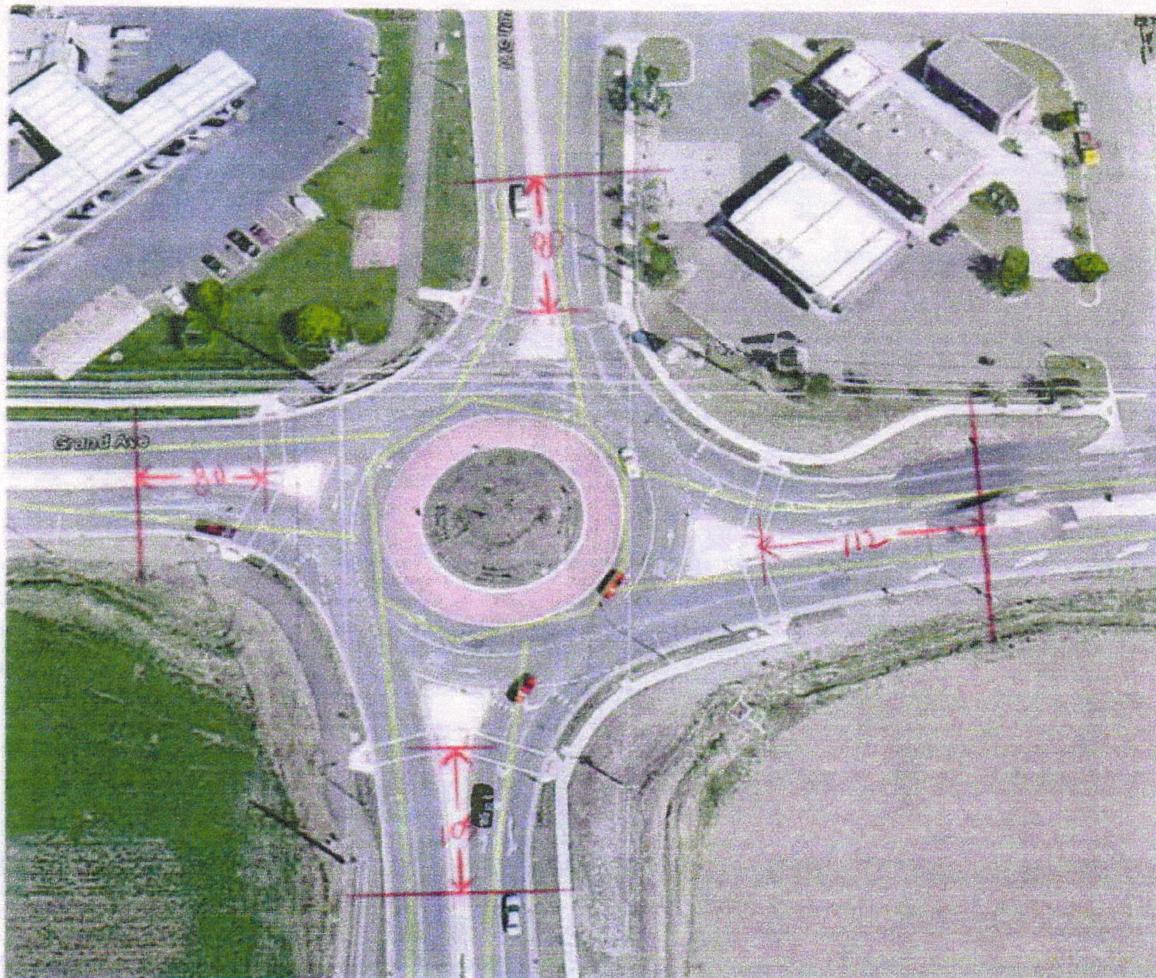

①	crosswalks	8	⑧	white fog line
②	shoulder teeth	8	⑨	yellow edge line
③	arrows →	4	⑩	white lane divider
④	arrows ↗	4	⑪	white strip
⑤	fish hooks straight	4	⑫	white islands 4
⑥	fish hooks left	4	⑬	yellow islands
⑦	only	4		

3874 57 W Grand Ave

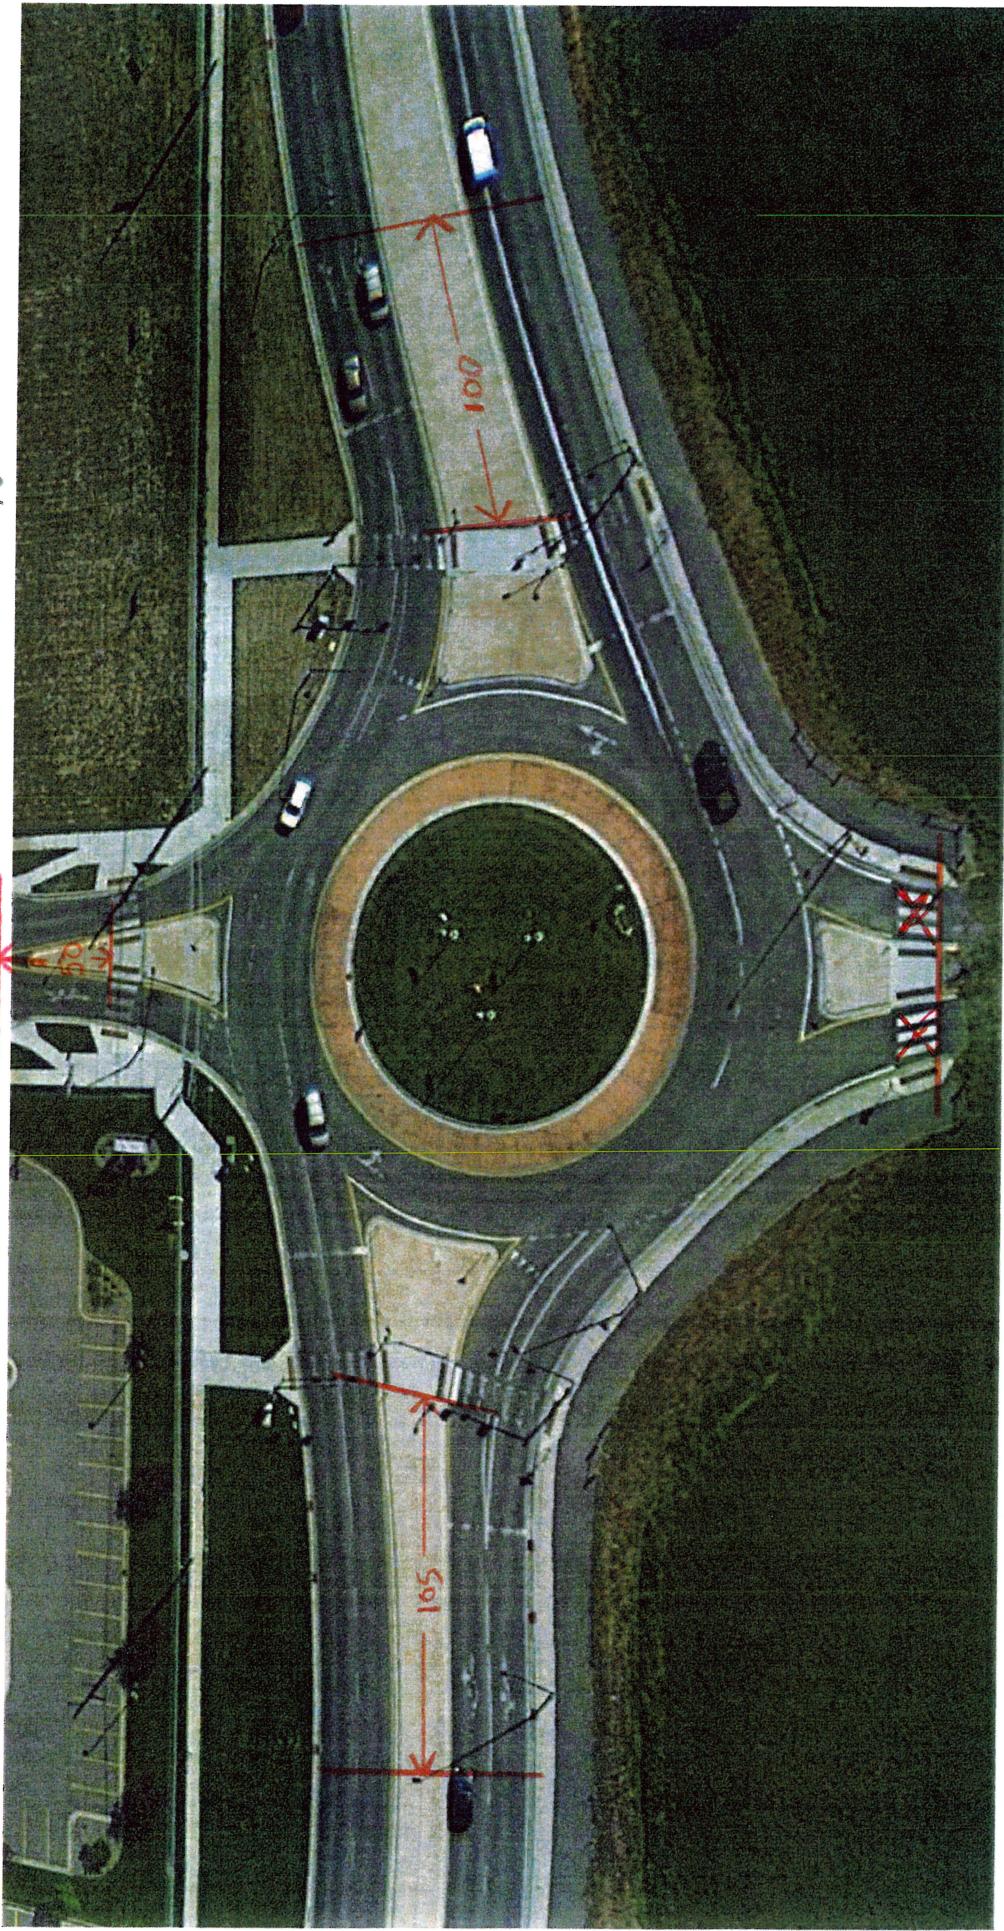

①	Crosswalks	6	⑧	FISH HOOKS STRAIGHT / LEFT / RIGHT	1
②	SHARKS TEETH	6	⑨	WHITE FOG LINE	
③	Arrows →	2	⑩	YELLOW EDGE LINE	
④	Arrows → →	4	⑪	WHITE LANE DIVIDER	
⑤	ONLYS	2	⑫	WHITE SKIP	
⑥	FISH HOOKS STRAIGHT / RIGHT	2			
⑦	FISH HOOKS STRAIGHT / LEFT	2			

36th St W + Grand Ave

N



- ① Cross Valves 6
- ② Sharks TEETH 6
- ③ Arrows → 2
- ④ Arrows ↓→ 4
- ⑤ Onlys 2
- ⑥ Fish Hooks STRAIGHT/RIGHT 2
- ⑦ Fish Hooks STRAIGHT/LEFT 2
- ⑧ White Fox LINE
- ⑨ Yellow EDGE LINE
- ⑩ White Lane DIVIDER
- ⑪ White Skip

Hilltop Road & Bench Blvd

① crosswalk 8
② shark teeth 5
③ arrow →
④ arrow →
⑤ arrow →
⑥ arrow →
⑦ only
fish hook
straight
⑧ fish hook left
⑨ fish hook right
⑩ white fish hook
⑪ yellow edge line
⑫ white lane divide
⑬ white skip
⑭ white painted
islands
⑮ yellow painted
islands

